

Final Operation, Maintenance, Repair, Replace, and Rehabilitate Manual

Howard Hanson Dam 1135 Fish & Wildlife Restoration Project Howard Hanson Dam, Washington



US Army Corps
of Engineers®

1. INTRODUCTION

This document outlines the responsibilities of the City of Tacoma and the U.S. Army Corps of Engineers (Corps) for the Howard Hanson Dam 1135 Fish and Wildlife Restoration Project (HHD 1135). The City of Tacoma, as project owner, is responsible for all aspects of normal operation and maintenance (O&M) of actions based on the physical condition that those actions were transferred.

It is anticipated that beginning in 2006, the Howard Hanson Dam (HHD) reservoir will be raised an additional 20 feet under the Corps/City of Tacoma's Additional Water Storage Project (AWSP). This action will effectively negate or significantly alter all of the efforts undertaken for the HHD 1135. Because of this change in operation, the City of Tacoma will only be responsible for the O&M of the HHD 1135 project until the AWSP becomes fully operational. At that time, all O&M requirements for the HHD 1135 will either be nullified or included into the AWSP's Restoration O&M plan based on negotiations between the Corps and the City of Tacoma at that time. If the AWSP does not become fully operational, then the City of Tacoma will be responsible for continuing O&M as specified in this document.

1.1 Project Purpose.

The purpose and objective of this project is to improve fish and wildlife habitat within the Howard Hanson Dam reservoir, and to help restore downstream natural river functions to improve habitat for resident and anadromous fish.

1.2 Authorization.

Section 1135, 1986 Water Resources Development Act as amended:
Environmental Protection and Restoration.

1.3 Location.

The Howard Hanson Dam (HHD) project is located on the Green River in King County, Washington, approximately 64.5 miles upstream from the mouth of the Green-Duwamish River System. The dam is approximately 35 miles southeast of Seattle and 25 miles east of Tacoma. The project lies entirely within the City of Tacoma's municipal watershed.

The project area includes the reservoir zone affected by the additional pool raise and the 64.5-mile stretch of the Green River below HHD that would be affected by the modification of the flow regime.

1.4 Site Description.

The dam is an earth-filled structure composed of rolled rock fill, a sand and gravel core, and rock shell protection. The dam is 235 feet high, has a total length of 675 feet, and is 960 feet thick at its base and 23 feet thick at the crest. The reservoir is approximately four miles long at its full conservation pool of 25,400 acre-feet, corresponding to a water surface elevation of 1,141 feet MSL.

The Green-Duwamish system varies considerably over the 64.5-mile stretch downstream from HHD. The lower part of this system is characterized by low gradient channel, constricted by levees, and with slightly higher gradient, a bottom substrate of gravels and cobbles, and a more natural and vegetated channel

bank. Significant salmonid spawning and rearing occurs in this reach. Between the Green River Gorge and HHD, the Green River is constricted by natural landforms, the gradient is moderate, and the substrate consists primarily of bedrock, boulders and large cobbles. This reach offers good rearing habitat, and a lesser amount of spawning habitat.

A detailed description of habitat/cover types found within the Green-Duwamish watershed is presented in the Section 1135 Environmental Assessment and the Feasibility Report completed in 1996.

1.5 Project Lands.

The project lies entirely within the City of Tacoma's municipal watershed.

1.6 Project Description.

This project consisted of several components including adding an additional 5,000 acre-feet of water behind the dam, the establishment of water tolerant plants within the inundation zone, expanding wildlife forage opportunities, creating a subimpoundment for wetland development, establish floating islands, and placing large woody debris (LWD) and rock clusters in reservoir tributaries.

Approximately 2,500 plants of Columbia sedge (*Carex aperta*), 500 willow staves and 50 Oregon ash trees were planted to provide varying vegetation along areas of the HHD reservoir that will provide forage and cover to fish and wildlife species, reduce bank erosion and sediment transport, and improve water quality.

1.7 Monitoring Programs.

Monitoring programs for Howard Hanson Dam section 1135 fish and wildlife restoration project includes several environmental actions. These actions include; monitoring the LWD, fish & wildlife islands, willow and Oregon ash plantings, sedge plantings, the sub impoundment, and fertilization and mowing of elk pastures. Monitoring recommendations are included in Section 2.1, General Rules and Procedures.

1.8 Construction History.

- 5,000 Additional Acre-feet: Authorization to begin holding 5,000 acre-feet of additional water was signed in 1996. Changes were made in dam's operation to allow for an increased volume of water and to hold for longer durations that when released, would help augment the downstream flows critical for fish migration during the mid-summer months. Within the reservoir, the longer period of inundation has the potential to reduce the density and change the composition of the plant community occurring below elevation 1,147 MSL. About 70 acres of non-aquatic habitats, including deciduous forest (23 acres), young coniferous forest (5.0 acres), mixed forest (4.6 acres), forested wetland (1.6 acres), scrub-shrub wetland (3.9 acres), emergent wetland/upland grassland (19.0 acres), mudflat (11.0 acres), and talus (1.0 acres), occur within the new portion of the proposed conservation pool, i.e., between elevations 1,141 feet MSL and 1,147 feet MSL.

- Sub-impoundment: Construction of the sub-impoundment was completed in the fall of 2001. An estimated 3,700 yards of material was used from the existing railroad grade and the “12-mile” borrow pit to bring the sub-impoundment up to an elevation of 1148 msl. At a narrow constriction point between the railroad grade and the adjacent hillside, material was used to fill in the gap to keep water from escaping on the inside of the railroad grade. A pre-existing culvert was modified to allow for a flapgate on the inside of the sub-impoundment and a fish screen on the reservoir side. The intent of this culvert is to allow water into the sub-impoundment, but not out. Willow staves and Oregon ash trees were planted throughout the sub-impoundment area.
- LWD Placement: Construction of the LWD in the North Fork and Mainstem Green River, and Gale Creek was completed in the fall of 2001. Approximately 250 logs of varying size, species, and condition were placed along stretches of the aforementioned rivers and creek to help provide aquatic habitat, aid in channel stability, and increase fish utilization. Approximately 700 yards of rock was used to cable the LWD in place to withstand varying flows and up to 20 feet of inundation. Epoxy was used to cable the LWD to rock.
- Willow, Oregon Ash, and Sedge Planting: The planting of willows and Oregon ash was done in fall of 2000 and the sedge planting was done in the fall of 2001. Willows along the N.F. Green River were planted into coir fabric mats for protection against wind and wave action during high pool, and to act as sediment collectors. Several plots were cleared and some willows were planted without coir matting to test the viability in comparison to those staves planted in coir matting. Oregon ash was planted at Gale Creek, and both willow and Oregon ash was planted at the sub-impoundment. Sedge mats measuring 4’x4’ were planted at elevations 1135 and 1141 below MacDonald Field.
- Floating Fish & Wildlife Islands: Nine floating islands were installed in the summer of 1999. Islands were constructed during low pool on bare ground using wood debris and log booms. The islands were anchored to an ecology block by chain. During the high pool the islands are floating.

Table 1. Estimated Project Costs

Engineering & Design (incl. modification to the HHD Water Control Plan) (P&S)	\$100,000
LERRD	\$84,480
Monitoring	\$6,000
Detailed Report Cost	\$61,500
Construction Cost	\$310,000

2. OPERATION AND MAINTENANCE GENERAL PROCEDURES

The project will be maintained in accordance with the following Project Cooperation Agreement (PCA), Article VIII – Operation, Maintenance, Repair, Replacement, and Rehabilitation (OMRR&R)

2.1 General Rules and Procedures.

2.1.1 Large Woody Debris

- Periodic inspections of the cables holding the LWD should be checked for fraying and destabilization. If fraying and/or destabilization does occur, the cable should be replaced and/or reattached using clamps or other means of stabilizing the log to keep it from floating away.
- Monitor the general position of the LWD jams to see if movement has occurred during the annual high pool and flood season. This task should be done annually after pool drawdown. Sketches and/or photographs recommended.



Sedge Plantings

- Survey the plantings twice a year monitoring survival success and potential spreading. Surveys should occur once before inundation, and once after inundation. Photographs would suffice in documenting survival success and spreading. Area measurements would help augment photographs for spreading success.
- Monitor sedge plants for grazing by wildlife species. If able, make a determination of either elk grazing or deer grazing given the signs around the sedges (droppings, tracks, etc.).



Tree Plantings

- Survey once a year during mid-summer checking for survival rate, browsing, etc. Representative photographs would suffice in documentation.



Fish & Wildlife Islands

- Do snorkeling surveys and creel surveys to determine if fish are utilizing structures; approximate numbers and species of fish. The HHD Corps personnel will assist in transportation only.
- Monitor the above-water portion of the island to identify wildlife use and/or the establishment of live vegetation. Document occurrences. The HHD Corps personnel will assist in transportation only.
- Visually check to see if any logs and/or debris need to be added. Add accordingly and document. The HHD Corps personnel will maintain responsibility for this portion of O&M.
- Ensure that anchoring system is functional. Do necessary maintenance to keep islands in place. The HHD Corps personnel will maintain responsibility for this portion of O&M.



Elk Pastures

- Mow grass two times a year at McDonald and Baldi field during early summer and late fall. Leave a buffer approximately 10 feet from forest edge.
- Reseed Baldi Field with a mixture of 40% blue wild rye, 40% red fescue, 20% orchard grass as needed and/or tri-annually.
- Fertilize Baldi Field every 5 years.
- Visually monitor elk usage as occasions arise. Document use and/or trends at Sponsor's discretion.



Sub Impoundment

- Visually inspect integrity of sub impoundment looking for cracks, slumps, seepage, and sloughing. Document with photographs.
- Annually inspect and clean the fish-barrier screen of debris.
- Annually inspect the flap gate for proper opening and closing. Provide periodic maintenance to ensure proper function.
- Monitor sub impoundment area during reservoir drawdown for leakage. Identify areas of leakage and document with photographs. Develop a timetable documenting the amount of time it takes the sub impoundment to fully drain over the course of a lowering pool.
- Do qualitative vegetation surveys on wetland species proliferation. Document information.
- Do qualitative wildlife surveys on wetland usage. Document information.




3. PROJECT COOPERATION REQUIRMENTS

The Corps and the City of Tacoma have entered into a PCA for this project on April 21, 2000, as required by Public Law (99-662). A copy of the duly executed PCA is included as Appendix A of the Manual.

3.1 Responsibility of Local Interests

The feasibility study lists the following responsibilities:

- For so long as the Project Modification remains authorized and viable, the Sponsor shall operate, maintain, repair, and rehabilitate the entire Project Modification as stated in Article XIII paragraph A and documented here in.
- Gives the Government a right to enter, at reasonable times and in a reasonable manner, upon property that the Sponsor owns or controls for access to the Project Modification for the purpose of inspection and if necessary, for the purpose of completing, operation, maintaining, repairing, replacing, or rehabilitating the Project Modification as stated in Article XIII paragraph B.
- Hold and save the Government free from all damages arising from the implementation, operation, maintenance, repair, replacement and rehabilitation of the Project Modification as stated in Article IX.

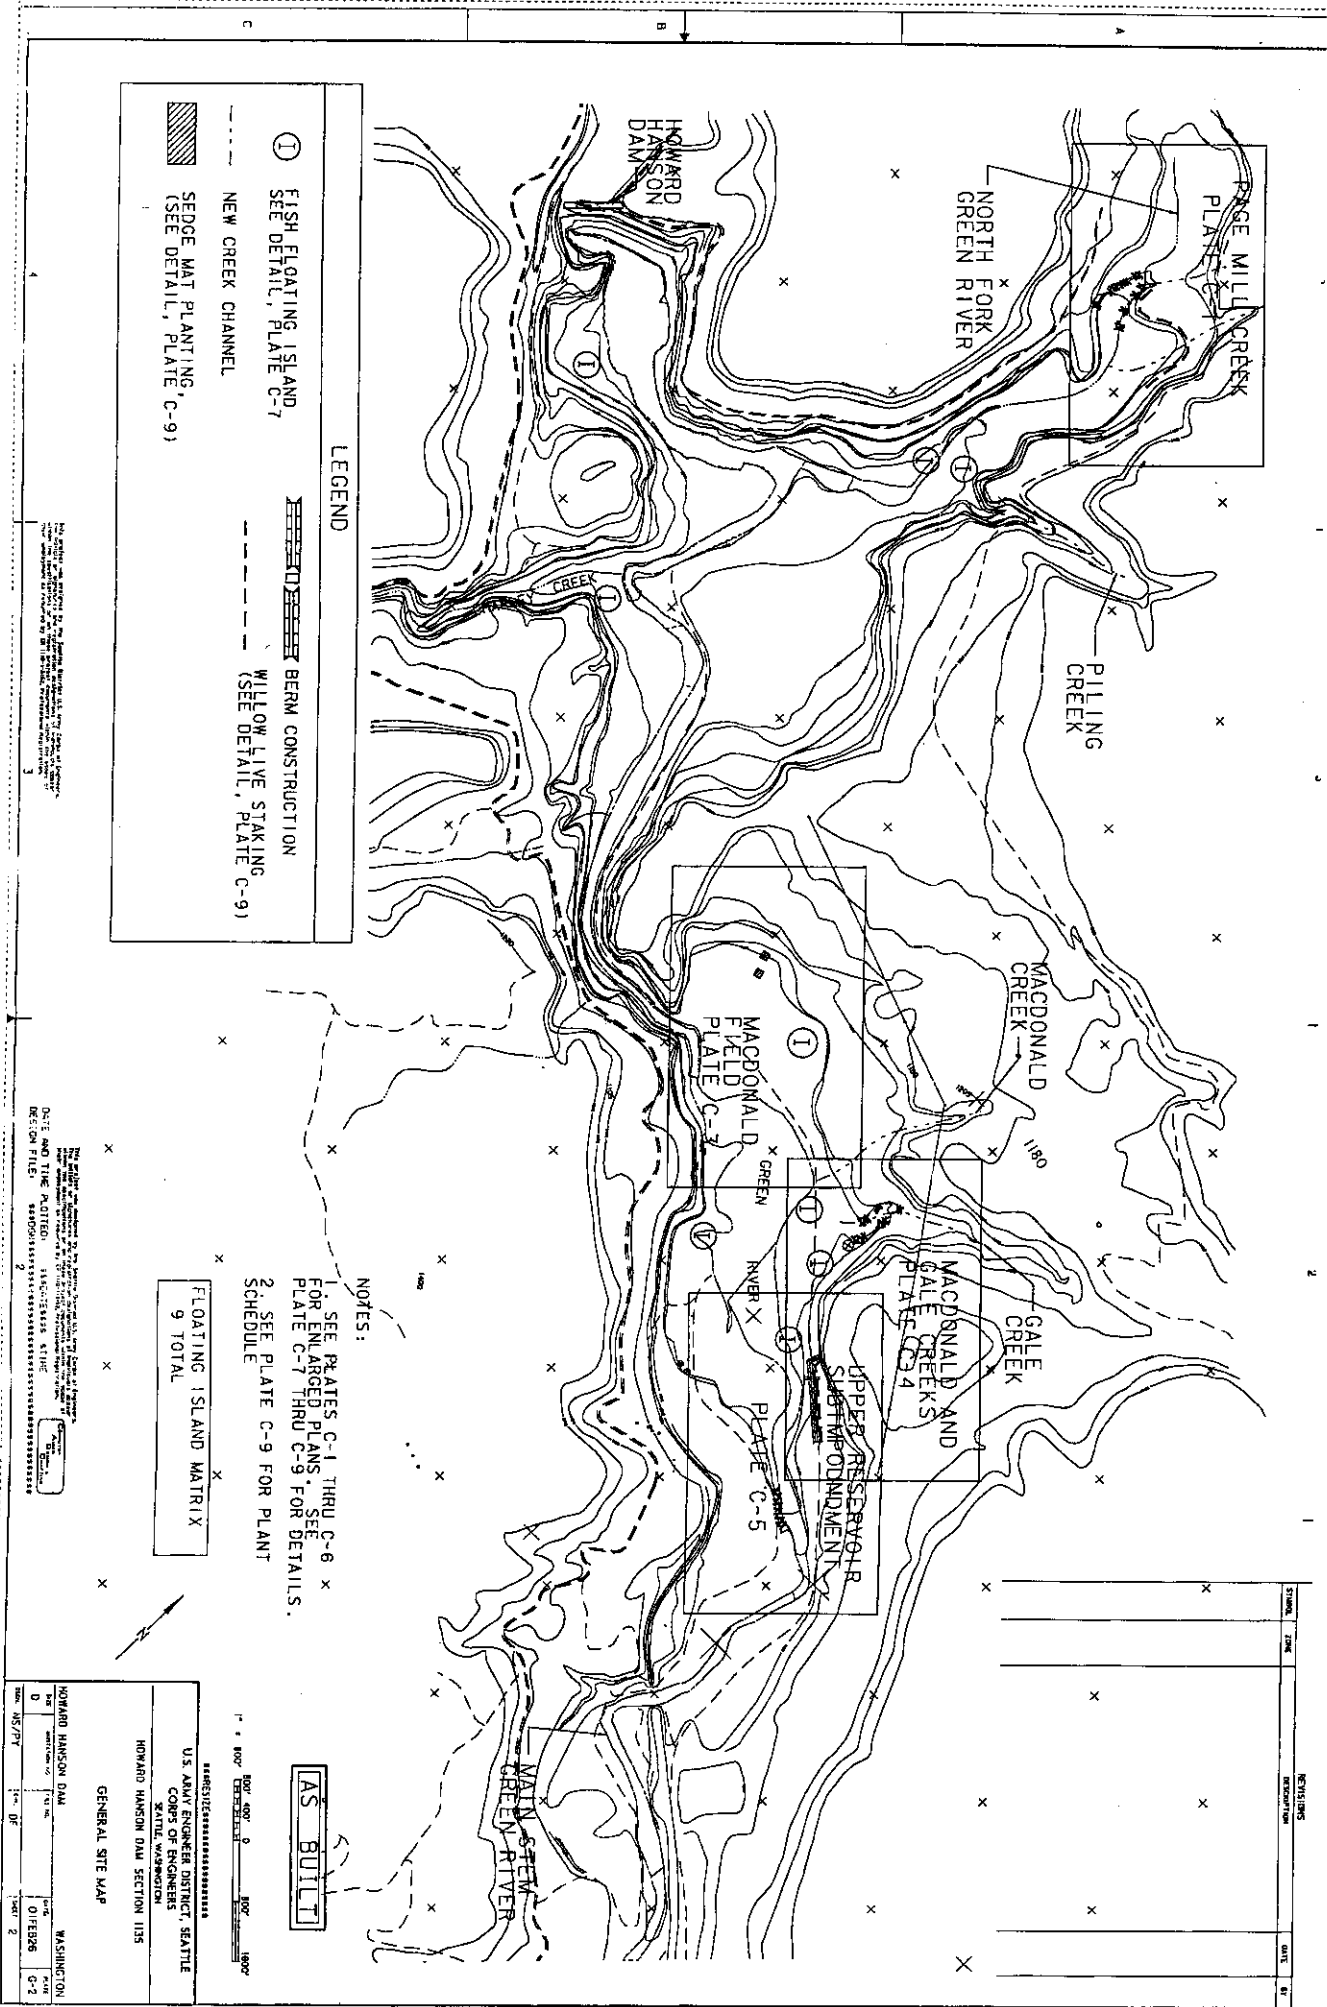

LEGEND

- ① FISH FLOATING ISLAND
SEE DETAIL, PLATE C-7
- NEW CREEK CHANNEL
- ▨ SEDGE MAT PLANTING
(SEE DETAIL, PLATE C-9)
- ▤ BERM CONSTRUCTION
- WILLOW LIVE STAKING
(SEE DETAIL, PLATE C-9)

The project was prepared by the Pacific Northwest Laboratory, Richland, Washington, for the U.S. Army Corps of Engineers, Seattle, Washington. The project was funded by the U.S. Army Corps of Engineers, Seattle, Washington. The project was completed in 1980.

DATE AND SCALE OF ORIGINAL DRAWING: 1978
 DESIGN FILE: 1135

NOTES:
 1. SEE PLATES C-1 THRU C-6 FOR ENLARGED PLANS. SEE PLATE C-7 THRU C-9 FOR DETAILS.
 2. SEE PLATE C-9 FOR PLANT SCHEDULE

FLLOATING ISLAND MATRIX
 9 TOTAL

AS BUILT


U.S. ARMY ENGINEER DISTRICT, SEATTLE
 CORPS OF ENGINEERS
 PACIFIC WASHINGTON DISTRICT
 HOWARD HANSON DAM SECTION 1135

GENERAL SITE MAP

HOWARD HANSON DAM
 SECTION 1135

WASHINGTON
 DATE: 01 FEB 80
 SHEET: 2

DATE	BY	REVISIONS

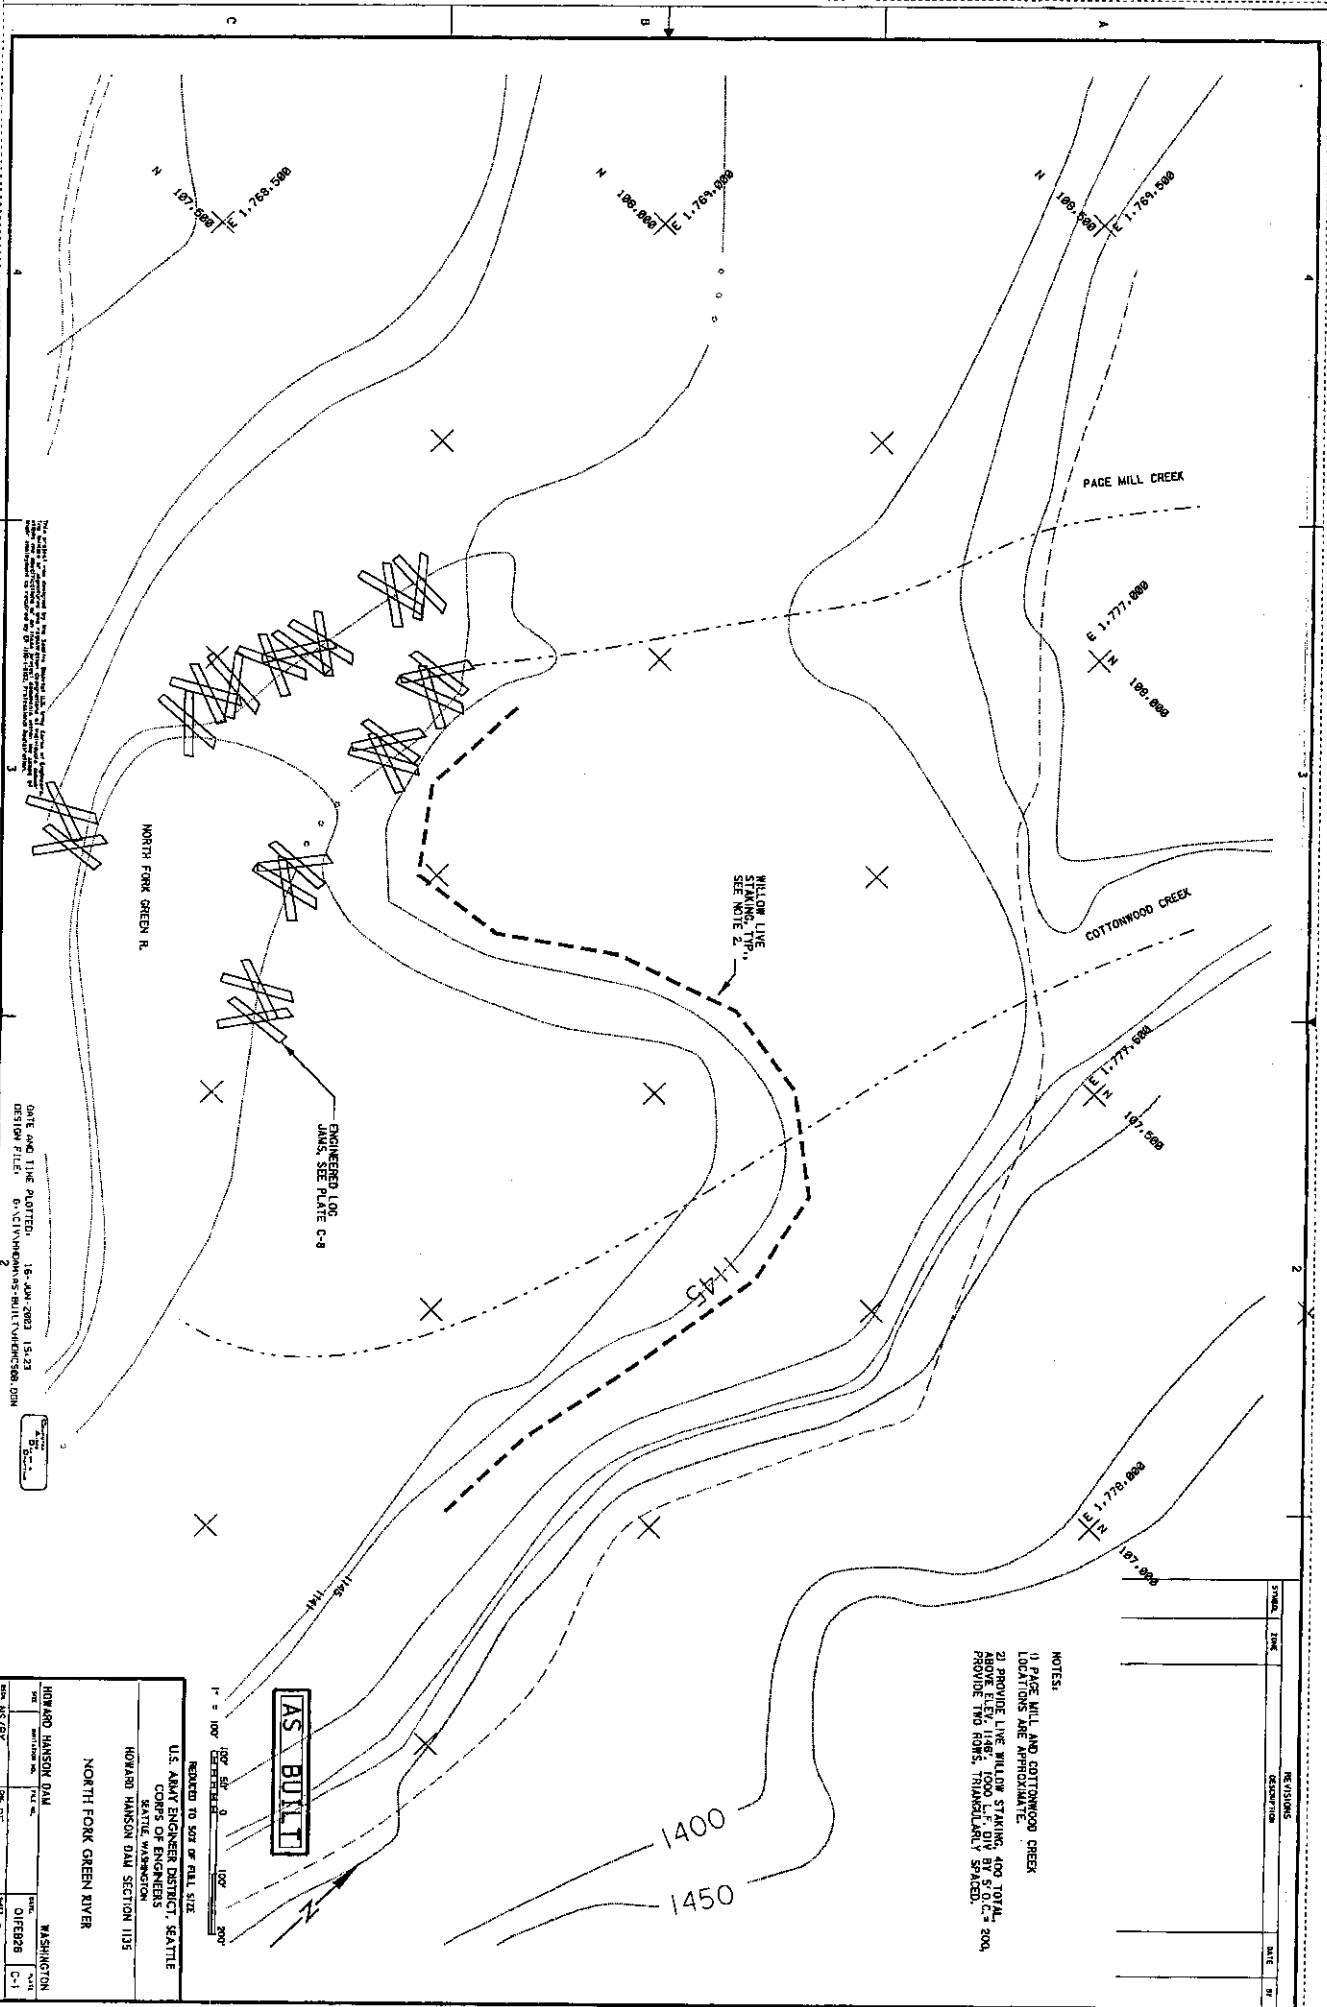

THE STATE ENGINEERING BOARD HAS REVIEWED THIS PLAN AND FINDS IT CONFORMS TO THE REQUIREMENTS OF THE WASHINGTON ENGINEERING ACT OF 1909, AS AMENDED, AND THE WASHINGTON WATER CONSTRUCTION ACT OF 1917, AS AMENDED, AND THE WASHINGTON WATER CONSTRUCTION ACT OF 1933, AS AMENDED, AND THE WASHINGTON WATER CONSTRUCTION ACT OF 1937, AS AMENDED, AND THE WASHINGTON WATER CONSTRUCTION ACT OF 1941, AS AMENDED.


DATE AND TIME PLOTTED: 15-JUN-2023 15:23
 DESIGN FILE: D:\CIVIL\WORKSPACE\STATE\WATER\2023\0304



AS BUILT
 REDUCED TO SEA LEVEL
 U.S. ARMY ENGINEER DISTRICT, SEATTLE
 CORPS OF ENGINEERS
 SEATTLE WASHINGTON
 HOWARD HANSON DAM SECTION 1135
 NORTH FORK GREEN RIVER
 HOWARD HANSON DAM
 WASHINGTON
 DATE: 01FEB88
 SHEET: C-1
 DRAWN: ASZ/PF
 CHECK: GE
 SHEET: 3

NOTES:
 1) PAGE MILL AND COTTONWOOD CREEK LOCATIONS ARE APPROXIMATE.
 2) PROPOSED LINE WILLOW STAKING 400 TO 600 FEET FROM DAM TO PROVIDE TWO ROWS, TRIANGULARLY SPACED.

NO.	DATE	DESCRIPTION	BY

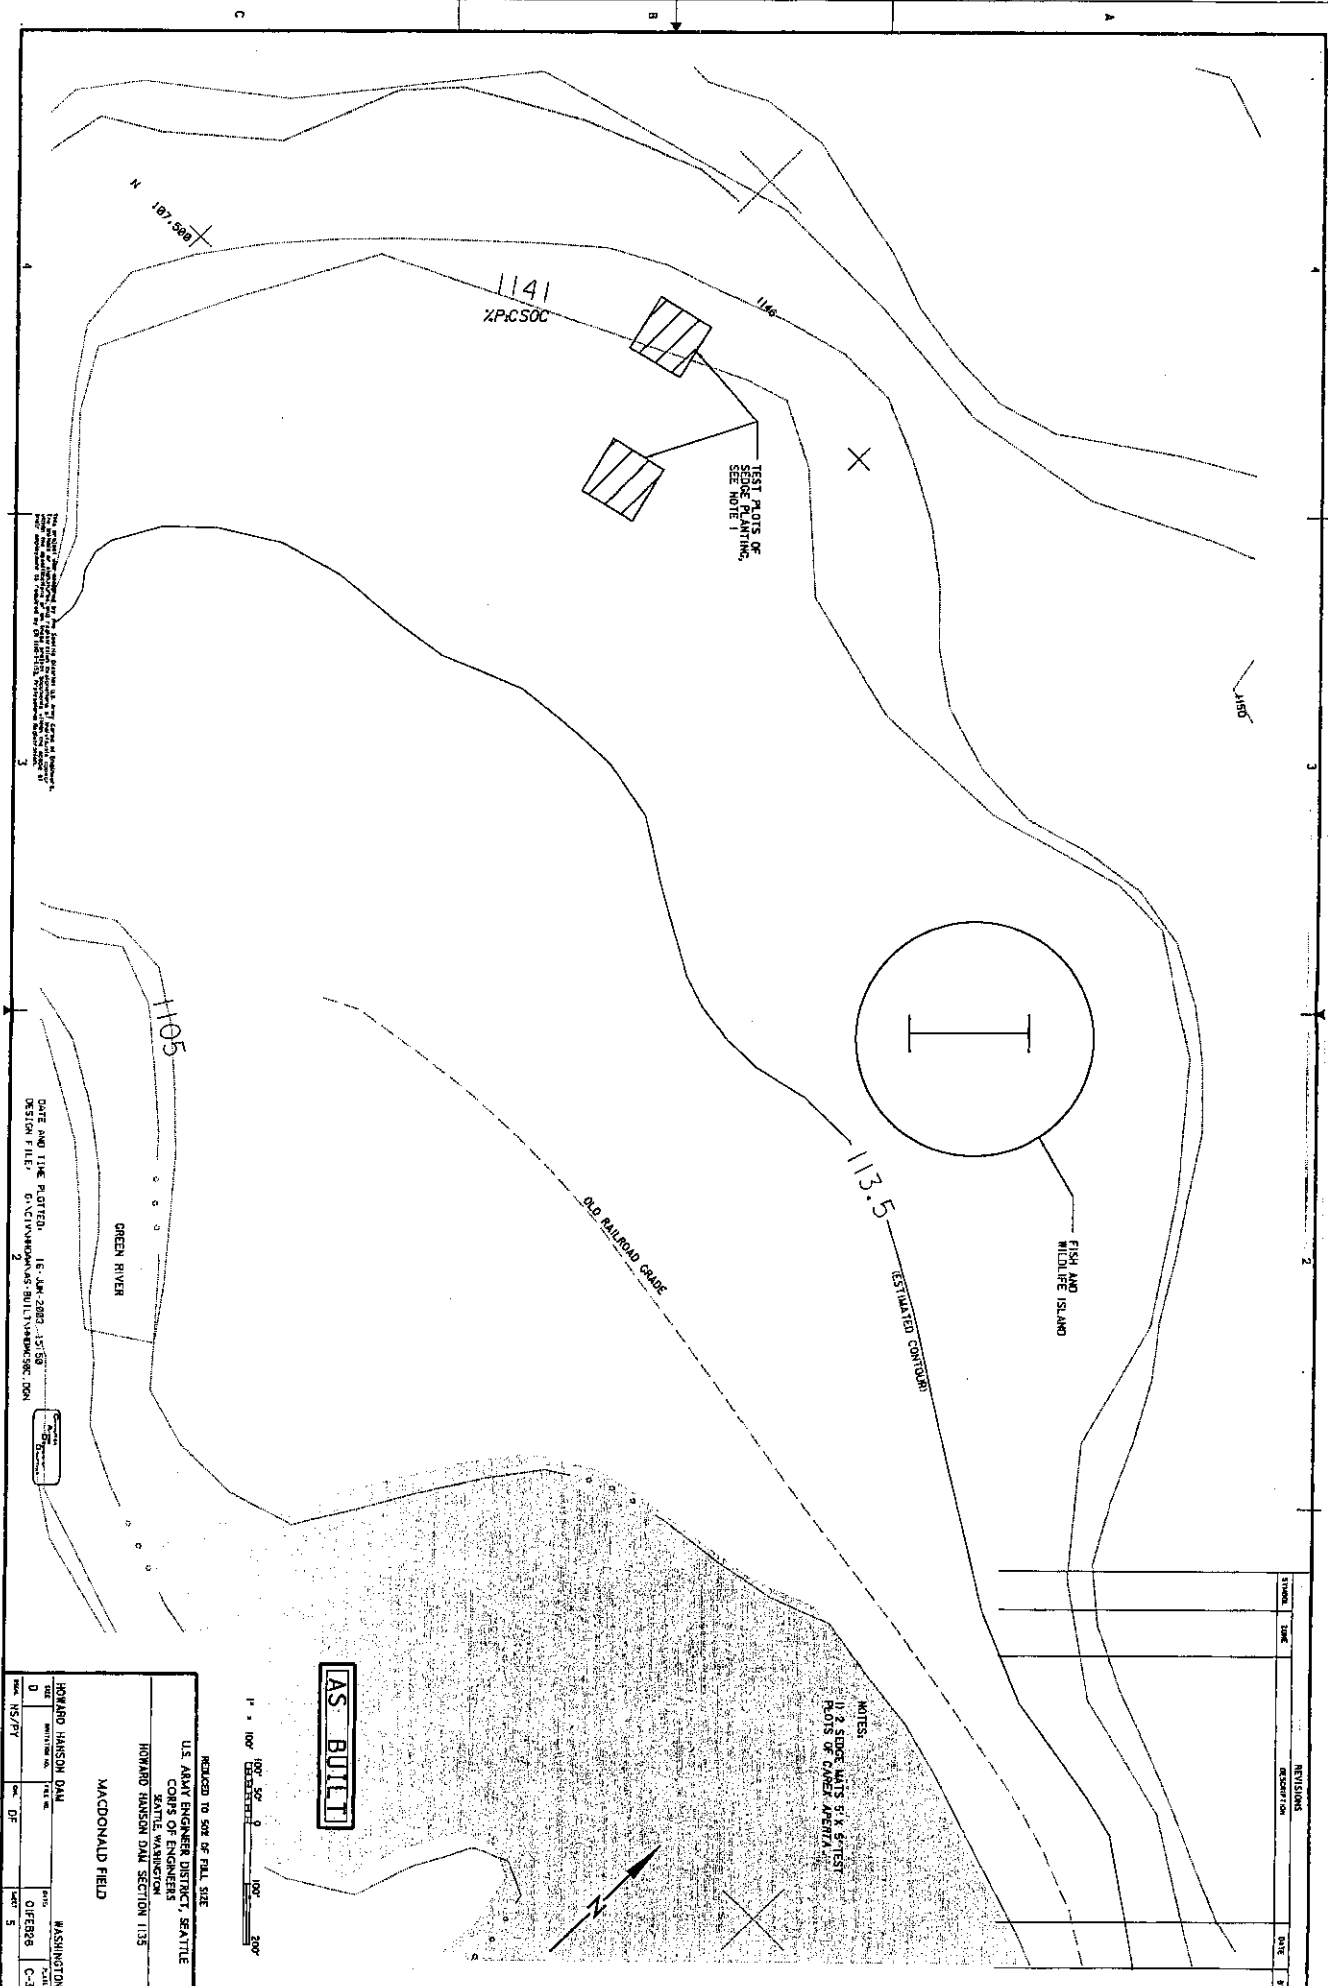

THIS PLAN IS THE PROPERTY OF THE U.S. ARMY ENGINEER DISTRICT, SEATTLE, WASHINGTON. IT IS TO BE KEPT IN THE OFFICE OF THE DISTRICT ENGINEER, SEATTLE, WASHINGTON. IT IS TO BE RETURNED TO THE DISTRICT ENGINEER, SEATTLE, WASHINGTON, UPON THE COMPLETION OF THE PROJECT. IT IS NOT TO BE REPRODUCED OR TRANSMITTED IN ANY FORM OR BY ANY MEANS, ELECTRONIC OR MECHANICAL, INCLUDING PHOTOCOPYING, RECORDING, OR BY ANY INFORMATION STORAGE AND RETRIEVAL SYSTEM.

DATE AND TIME PLOTTED: 15 JAN 2003 13:53
 DESIGN FILE: C:\NVA\WORKSPACE\BUILT\HW\HW.DWG

HOWARD HANSON DAM		WASHINGTON	
DATE	15 JAN 2003	TIME	13:53
DESIGNER	D	CHECKER	OJF828
SCALE	AS SHOWN	SECTION	C-3
PROJECT	NS/PV	DATE	5

REDUCED TO SIZE OF PLOT SIZE

U.S. ARMY ENGINEER DISTRICT, SEATTLE
 CORPS OF ENGINEERS
 SEATTLE, WASHINGTON
 HOWARD HANSON DAM SECTION 1135


MACDONALD FIELD

AS BUILT



NOTES:
 1. 2 SAND MATS 6' X 6' TEST PLOTS OF GREEN ALGAE.

REVISION	DATE	BY

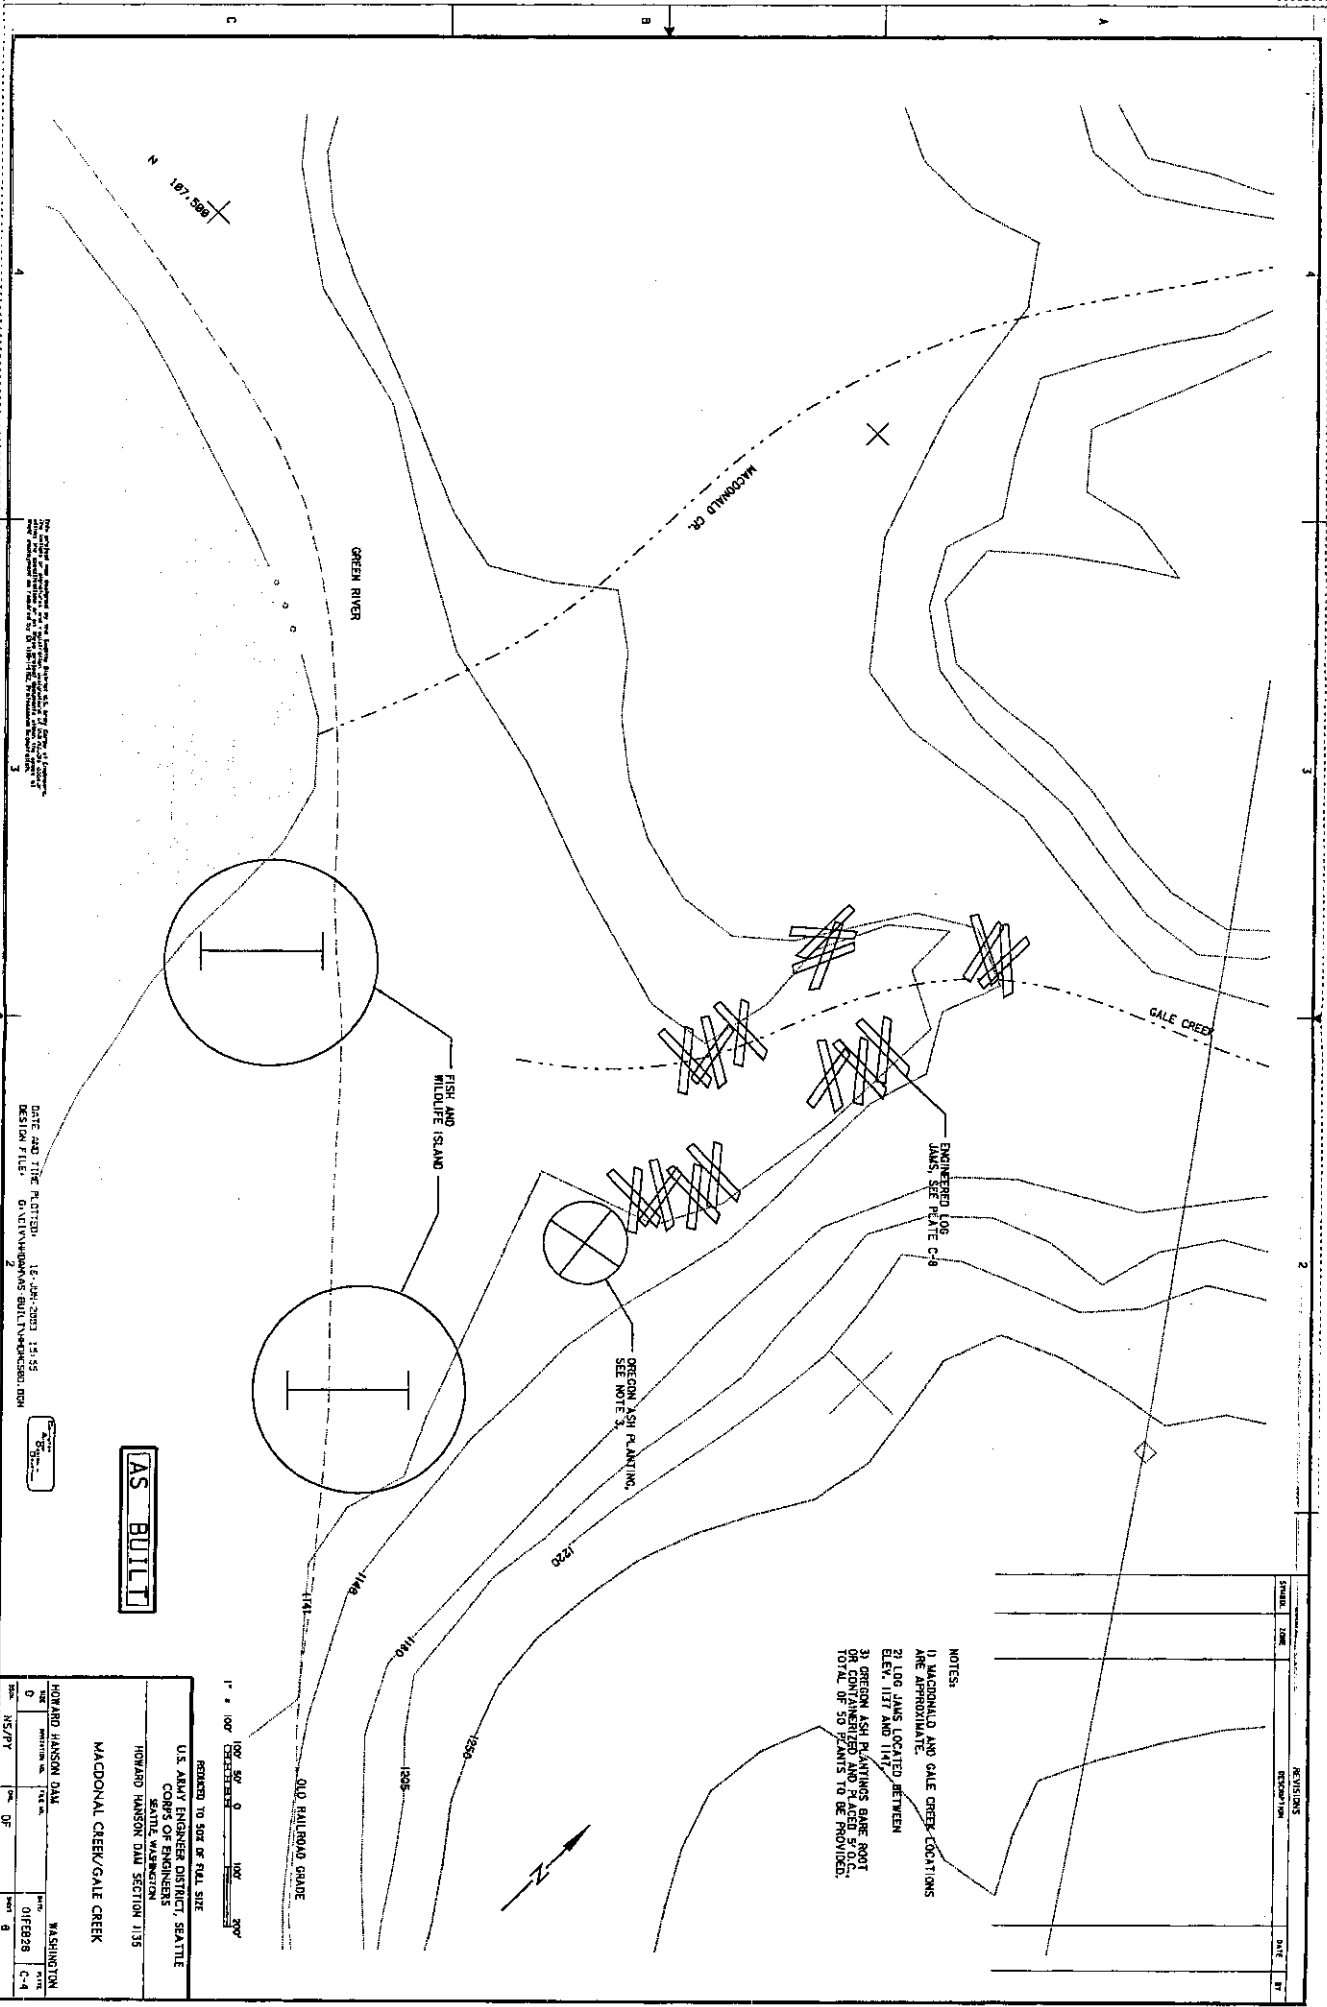

THE ENGINEER HAS CONDUCTED A VISUAL SURVEY OF THE AREA SHOWN ON THIS MAP. THE LOCATION OF THE ENGINEERED LOG JAMS AND OREGON ASH PLANTING IS APPROXIMATE. THE LOCATION OF THE OREGON ASH PLANTING IS APPROXIMATE. THE LOCATION OF THE OREGON ASH PLANTING IS APPROXIMATE.

DATE AND TIME PLACED: 16 JAN 2003 15:55
 DESIGN FILE: D:\NVA\HANSON\BUILT\HANSON\BUILT



AS BUILT

HOWARD HANSON DIAL		WASHINGTON	
DATE	TIME	DATE	TIME
0		01/28/03	C-4
NO.	OF	NO.	OF
1	1	1	1

1" = 100' GRAPHIC SCALE

REDUCED TO SEA OR FULL SIZE

U.S. ARMY ENGINEER DISTRICT, SEATTLE

COMPANY OF ENGINEERS


SEATTLE, WASHINGTON

HOWARD HANSON DIAL SECTION 1135

MACDONALD CREEK/GALE CREEK

- NOTES:
- 1) MACDONALD AND GALE CREEK LOCATIONS ARE APPROXIMATE.
 - 2) LOG JAMS LOCATED BETWEEN ELEV. 1137 AND 1147.
 - 3) OREGON ASH PLANTINGS BARE ROOT OR CONTAINERIZED AND PLACED S.T.O. 101 AL OR 50 PLANTS TO BE PROVIDED.

REVISIONS	DATE	BY

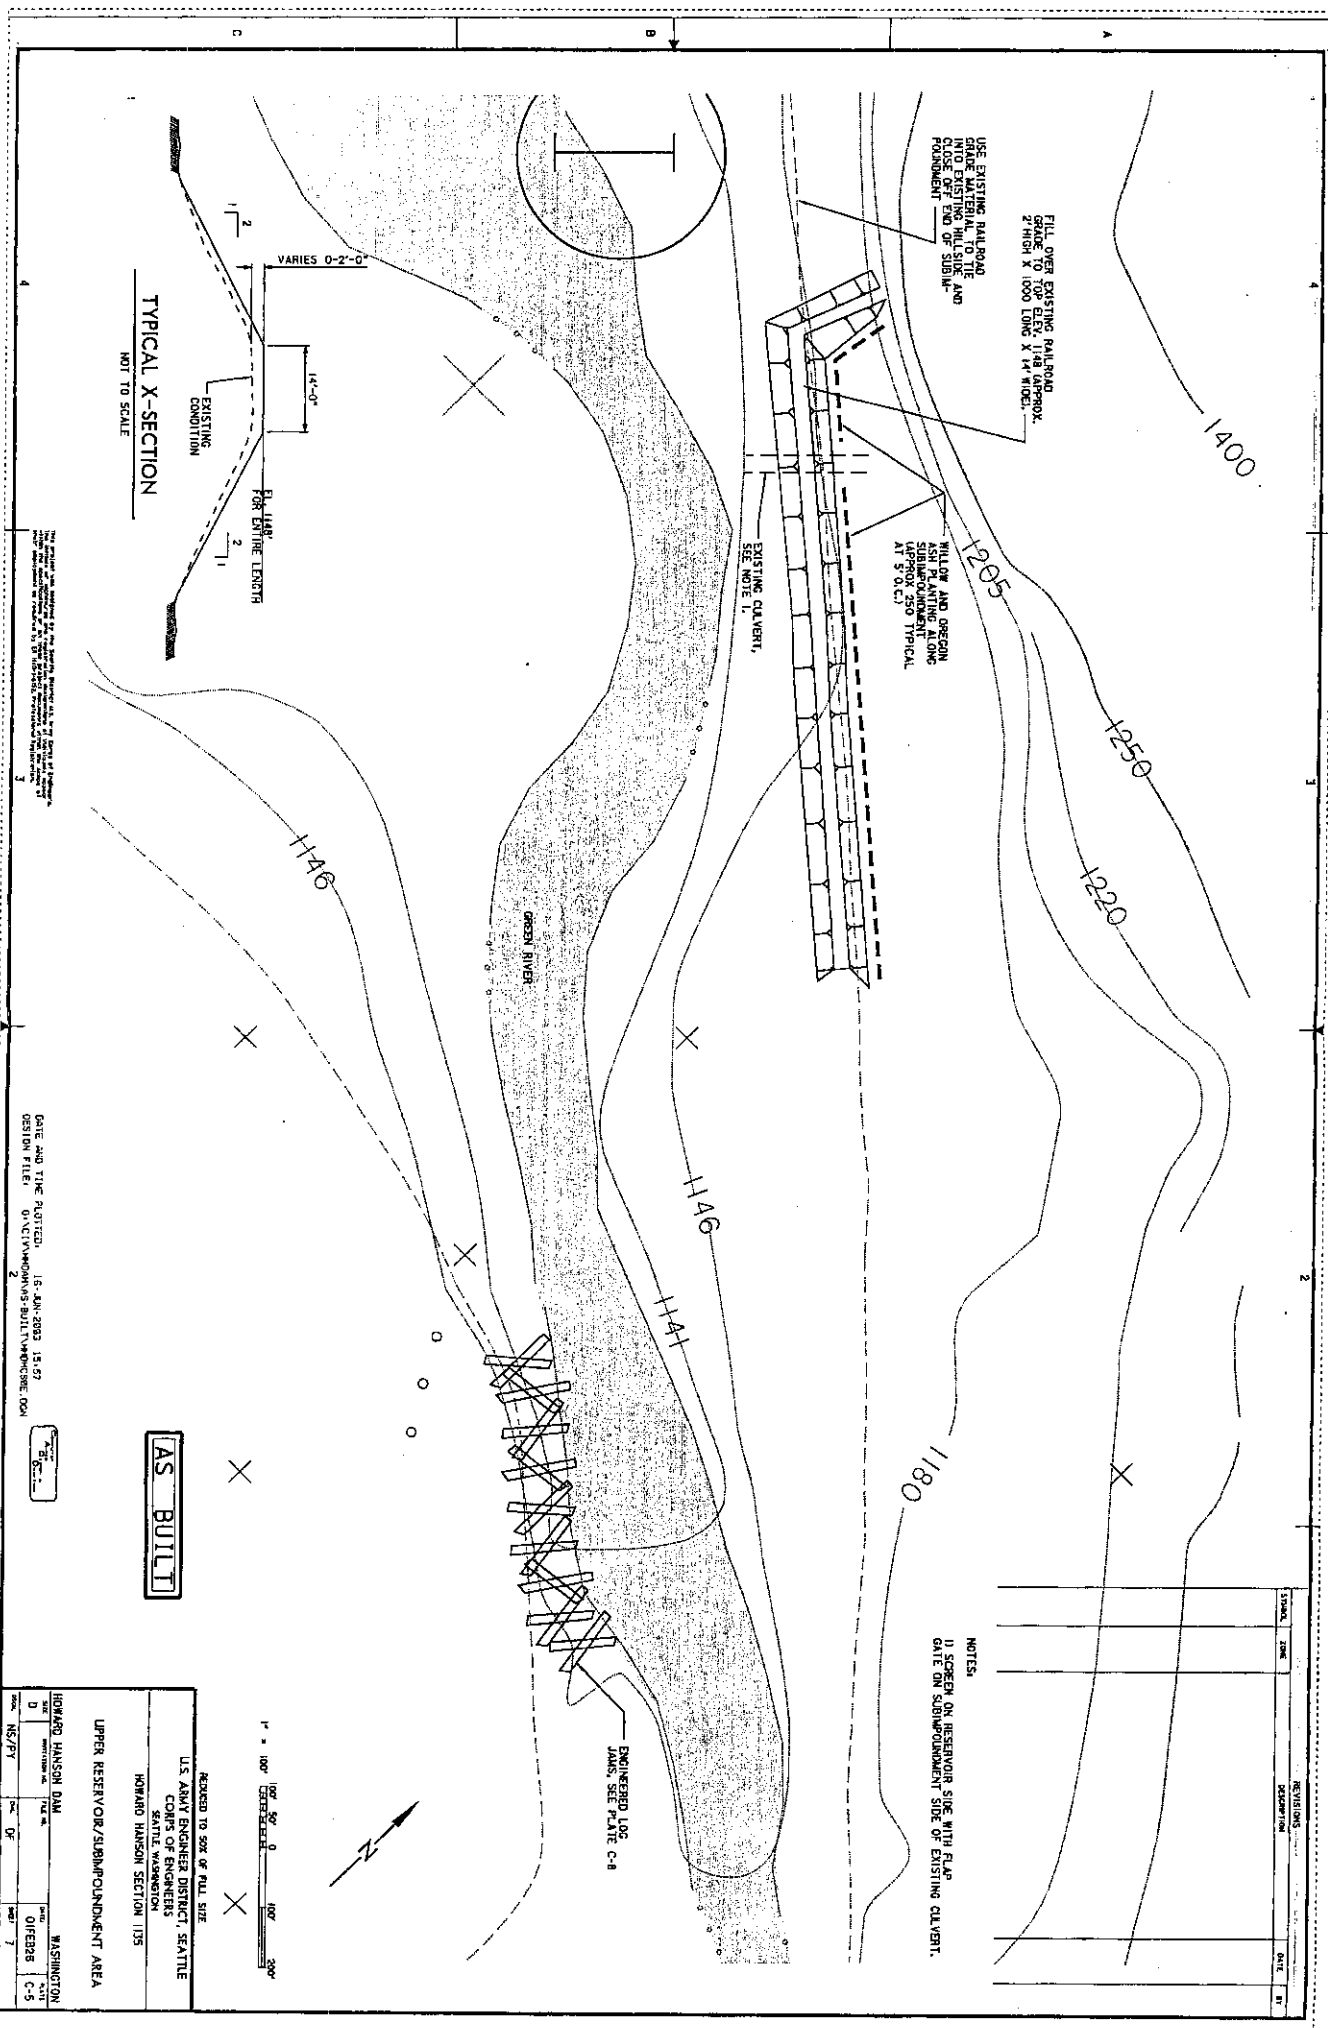

FILL OVER EXISTING RAILROAD GRADE TO TOP ELEV. 1148 (APPROX. 2' HIGH X 1000' LONG X 14' WIDE).
 USE EXISTING RAILROAD GRADE MATERIAL TO THE END OF EXISTING HILL SIDE AND FILL TO SUB-FOUNDATION APPROX. 250' TYPICAL AT 3' O.C.

FILL ON AND OFF-ROAD SUB-FOUNDATION APPROX. 250' TYPICAL AT 3' O.C.

EXISTING CAVERT, SEE NOTE 1.

ENGINEERED LOG DAM, SEE PLATE C-8

TYPICAL X-SECTION
 NOT TO SCALE

THE DESIGN AND CONSTRUCTION OF THIS DAM IS THE RESPONSIBILITY OF THE DISTRICT ENGINEER, U.S. ARMY ENGINEER DISTRICT, SEATTLE, WASHINGTON. THE DESIGN AND CONSTRUCTION OF THIS DAM IS THE RESPONSIBILITY OF THE DISTRICT ENGINEER, U.S. ARMY ENGINEER DISTRICT, SEATTLE, WASHINGTON.

GATE AND TRUSS PARTS: 15, 40, 2003, 15, 57
 DESIGN FILE: D:\CIVIL\ENGINEERING\BUILT\WASHINGTON\HOW

AS BUILT


NOTES:
 1) SCREEN ON RESERVOIR SIDE WITH RAP GATE ON SUBIMPOUNDMENT SIDE OF EXISTING CAVERT.

HOWARD HANSON DAM		WASHINGTON	
U.S. ARMY ENGINEER DISTRICT SEATTLE		CORPS OF ENGINEERS	
SEATTLE WASHINGTON		HOWARD HANSON SECTION 135	
UPPER RESERVOIR/SUBIMPOUNDMENT AREA		DATE: 01/28/88	
DESIGNER: D	SCALE: NS/FT	DATE: 01/28/88	BY: C-5

1" = 100' GRAPHIC SCALE



NO.	DATE	BY

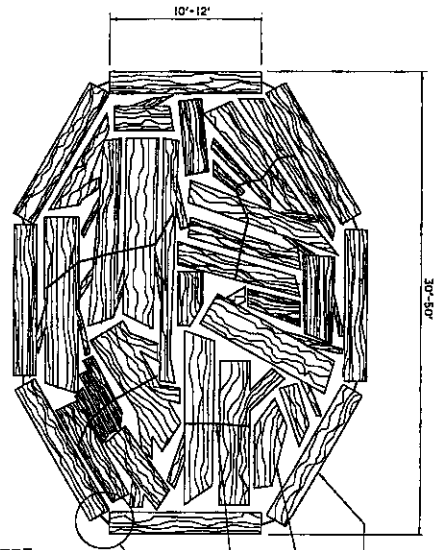


NOTE: PROVIDE ANCHORING OF ISLANDS AS INDICATED, MINIMUM TWO LOCATIONS EACH ISLAND. ISLANDS MAY BE LINKED TOGETHER OR SEPARATED AS APPROPRIATE.

OLD LOG BOOM LOGS CABLED TO PROVIDE MIN. 30" DIAMETER ISLAND.

MISC. WOODY DEBRIS FROM RESERVOIR, ATTACHED OR.

TIGHTLY PACK AND GABLE TOGETHER WOODY DEBRIS AND TOPSOIL (NATIVE SOIL) TO TOP OF DEBRIS. BIND ISLAND Q.M.L.Y.

FLOATING ISLAND - PLAN
NOT TO SCALE

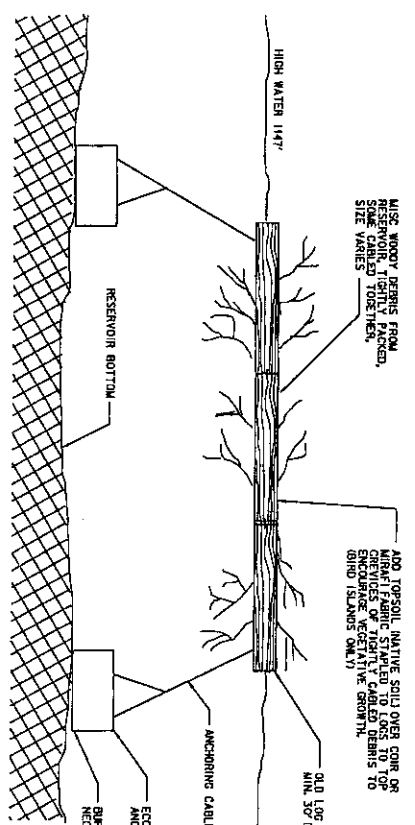

FLOATING ISLAND - SECTION
NOT TO SCALE

MISC. WOODY DEBRIS FROM RESERVOIR, TIGHTLY PACKED TOGETHER. SIZE VARIES.

ADD TOPSOIL, NATIVE SOIL OVER CORN OR OTHER FERTILE SOILS TO TOP OF DEBRIS OR TIGHTLY CABLED DEBRIS TO BIND ISLANDS Q.M.L.Y.




OLD LOG BOOM LOGS CABLED TO PROVIDE MIN. 30" DIAMETER ISLAND FOR DEBRIS.

ANCHORING CABLE (TYP.)

ECOLOGICAL BLOCK OR SIMILAR ANCHORS, MIN. TWO PER ISLAND, BURY 6"-8" IF NECESSARY.

NOTES:
1. SET ANCHORS BELOW ELEVATION TO ASSURE FISH ISLANDS FLOAT IN OCTOBER AND NOVEMBER, AND BIRD ISLANDS FLOAT FROM APRIL THROUGH JUNE.
2. ISLANDS WILL SIT ON RESERVOIR BOTTOM DURING LOW WATER CONDITIONS.

DESIGNED BY: HOWARD HANSON DAW
DRAWN BY: J. W. HANSON
CHECKED BY: J. W. HANSON
DATE: 11-28-83
PROJECT: BULLWATER CREEK

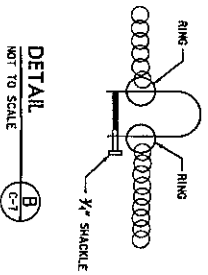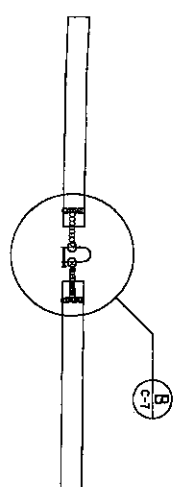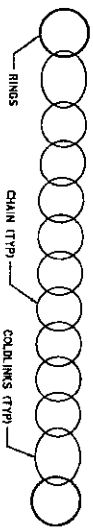

DETAIL B
NOT TO SCALE

NOTE: A DEVICE SIMILAR TO A CHAIN-CHAIN IS USED TO SECURE THE RING, AROUND THE END OF LOG. THIS IS 6" STAPLES.

CHAINING DETAIL A
NOT TO SCALE

BUILDING OF BOOM LOGS FOR FISH/BIRD ISLANDS

- USE 1/2" CHAIN WITH RINGS WELDED ON 12"-14" LENGTHS OF CHAIN.
- ATTACH TO 30'-50" BOOM LOGS CHAINING LOG AT BOTH ENDS WITH CHAIN STRAPS AND SECURING WITH 6" STAPLES.
- ATTACH LOG ENDS WITH 3/4" SHACKLES.
- PRINCE FOR 14" CHAIN STRAP WITH RINGS ON BOTH ENDS.

A. 1/2" CHAIN (14' LONG @ \$24)	\$1704
B. 2" COLD LINKS (200)	\$200
C. 2 3/4" RINGS (50)	\$150
TOTAL	\$2054 (R12/ISLANDS)

PRAYS ARE WITH BALL INDUSTRIES STAPLES ARE MADE BY A LOCAL WENGER IN ENCLAVE.



- USING 8 BOOM LOGS PER ISLAND, INCLUDING THE CHAIN FOR ANCHORING, WE WILL NEED APPROX. 200' OF CHAIN 30'-50" WELDED RINGS, AND 30-1/2" COLD LINKS, AND ABOUT 30 STAPLES.

AS BUILT

HOWARD HANSON DAW		WASHINGTON	
DATE	11/28/83	DATE	01/28/88
BY	J. W. HANSON	BY	J. W. HANSON
CHECKED BY	J. W. HANSON	CHECKED BY	J. W. HANSON
PROJECT	BULLWATER CREEK	PROJECT	BULLWATER CREEK
SCALE	AS BUILT	SCALE	AS BUILT

NO.	DATE	DESCRIPTION

REVISIONS	DATE	BY

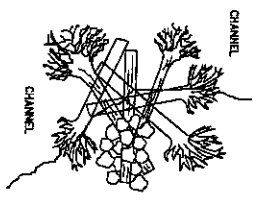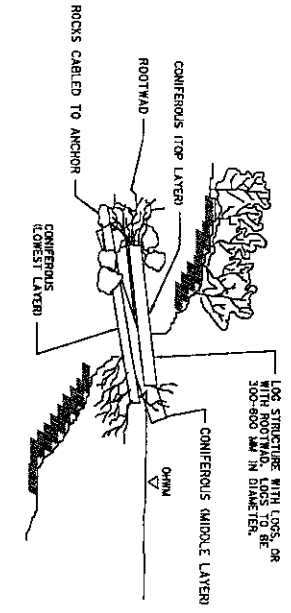

ENGINEERED LOG JAM
NOT TO SCALE

AS BUILT

HOWARD HANSON DAM U.S. ARMY ENGINEER DISTRICT, SEATTLE CORPS OF ENGINEERS SEATTLE, WASHINGTON HOWARD HANSON DAM SECTION 1135 DETAILS II		WASHINGTON PROJECT C-8 DATE FEBRUARY 1977	
DATE AND TYPE PLOTTED 11 JAN 2883 11:41	DESIGN FILE 9 0 1 2 100	DRAWN BY MLC	CHECKED BY MLC

THIS DRAWING IS THE PROPERTY OF THE U.S. ARMY ENGINEER DISTRICT, SEATTLE. IT IS TO BE USED ONLY FOR THE PROJECT AND LOCATION SPECIFICALLY IDENTIFIED HEREON. IT IS NOT TO BE REPRODUCED, COPIED, OR TRANSMITTED IN ANY FORM OR BY ANY MEANS, ELECTRONIC OR MECHANICAL, INCLUDING PHOTOCOPYING, RECORDING, OR BY ANY INFORMATION STORAGE AND RETRIEVAL SYSTEM, WITHOUT THE WRITTEN PERMISSION OF THE U.S. ARMY ENGINEER DISTRICT, SEATTLE.